

This product includes mapping data licensed from Ordnance Survey with the permission of HMSO © Crown Copyright LBH 2011. All rights reserved. License number 100019199.

PEDESTRIAN and CYCLE ZONE




Mon - Fri
8:00 - 9:15am
2:30 - 3:45pm

Except permit holders SS1

NOTES:

- Proposed School Street
- Proposed cycle/ped zone sign & post
- LC Existing lamp column
- Proposed no loading at any time restriction to be introduced on junction corners
- Properties eligible for a school street exemption permit

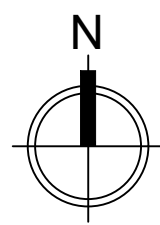

Rev	Description	Checked	Date

Project: COVID 19 REACTIVE WORKS

Title: Chestnuts Primary

Path: S:\EN\Sr\Scri\High\Sr\FAIP\Sustainable Transport\TPP Group\.....

Designed: AH Drawn: AH Checked: ##


Scale: NTS @A3 Date Drawing Created: 10.06.2020

Drg. No: RJHWP-###-ref Rev: -

PLACE & SUSTAINABILITY SINGLE FRONTLINE
5th Floor, Alexandra House, 10 Station Road, Wood Green, London N22 7TR
Tel: 020 8489 0000 Fax: 020 8489 1251
Director Place and Sustainability: Lyn Garner



www.haringey.gov.uk

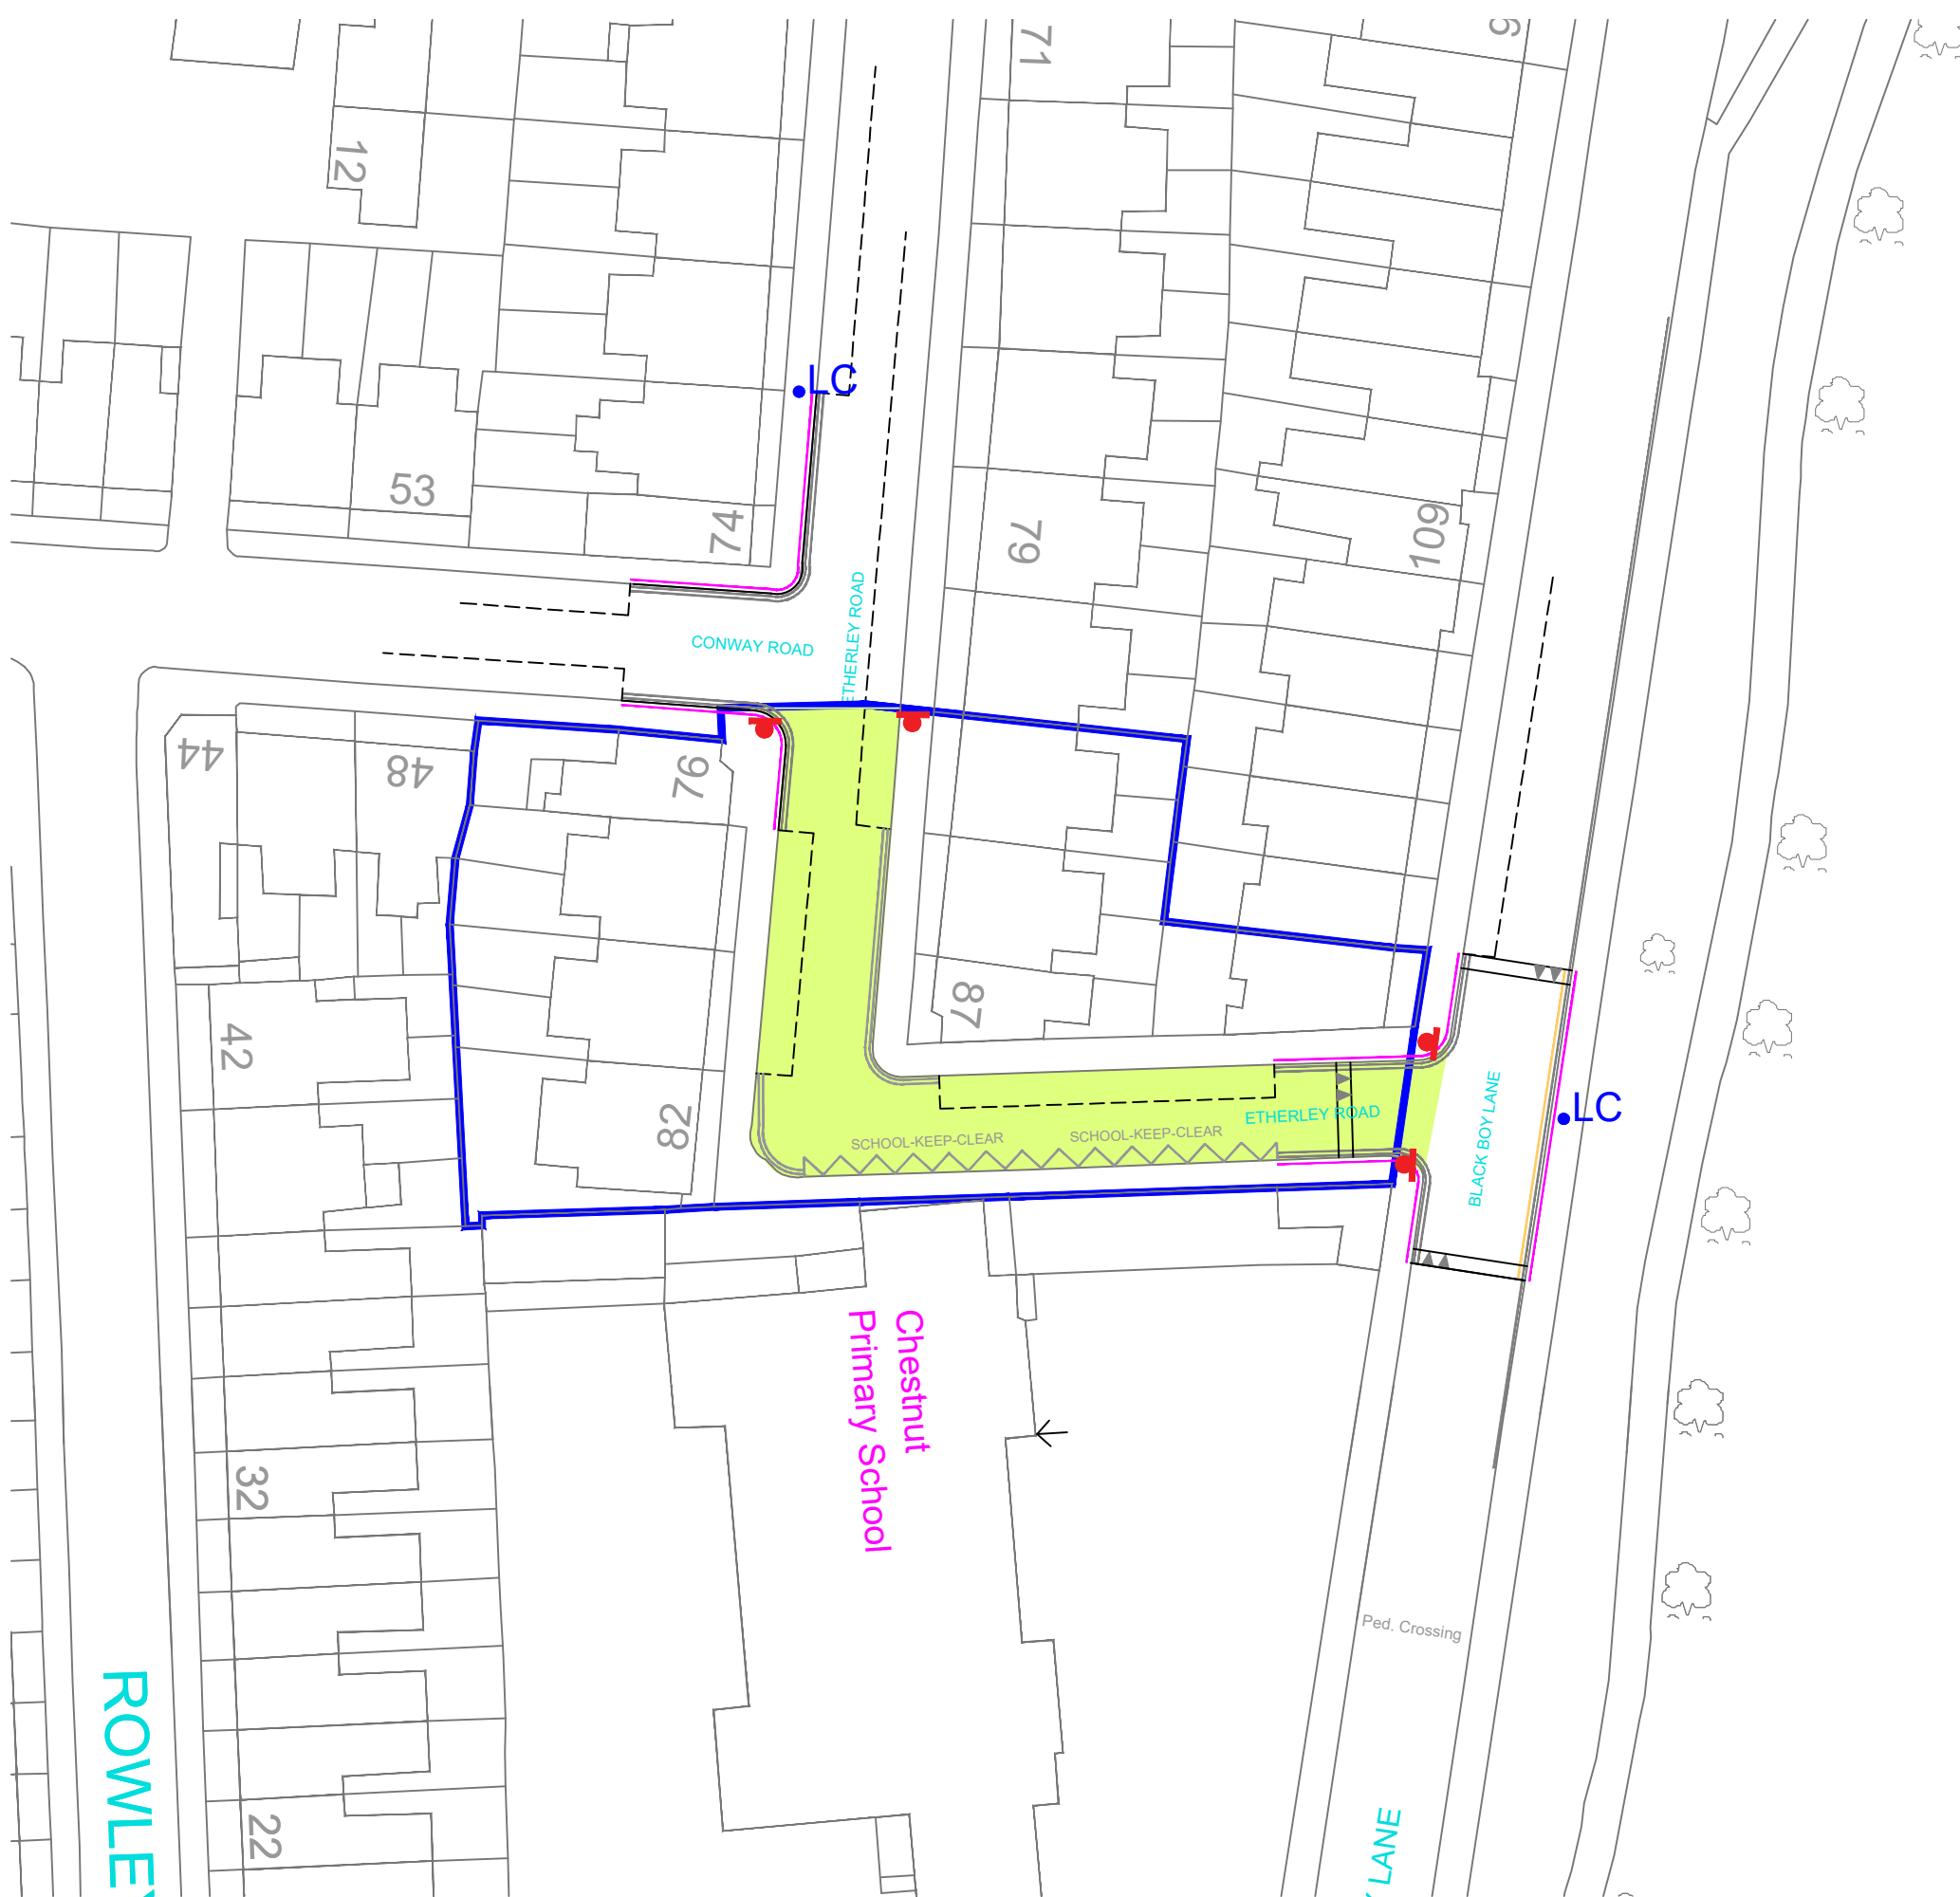

ROWLEY

Chestnut Primary School